


**DART**



DESIGN	B WILLIAMS	DRAWN BY	B WILLIAMS	DART AEROSPACE LTD VICTORIA INTERNATIONAL AIRPORT, CANADA	REV. C
CHECKED	B WILLIAMS	APPROVED	B WILLIAMS	D2289	SHEET 1 OF 1
DATE	94.12.21	TITLE	VALVE MOUNTING BRACKET	SCALE	1:2
C	96.01.15	CORRECTED	FLAT PATTERN		

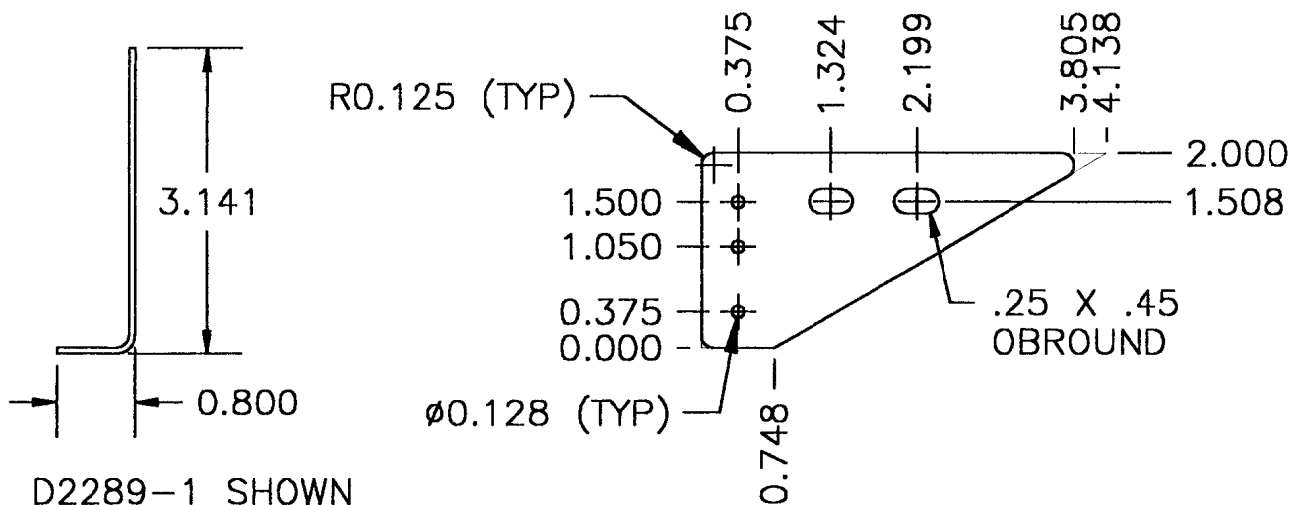



D2289-1 SHOWN  
D2289-2 OPPOSITE

**UNDER REVIEW**

~~07.02.12 CB~~

~~update dwg~~

07.02.14  
CB  
dwg will  
not be  
updated

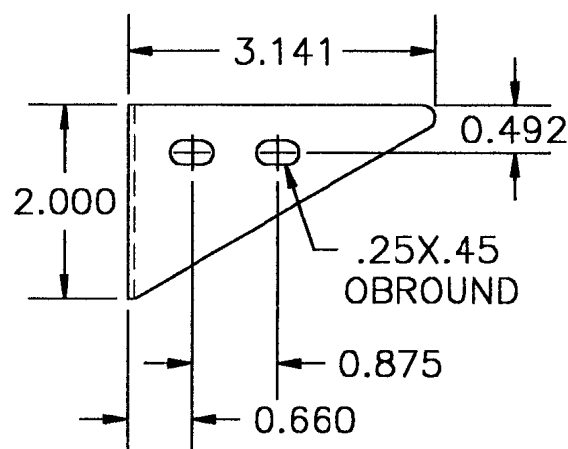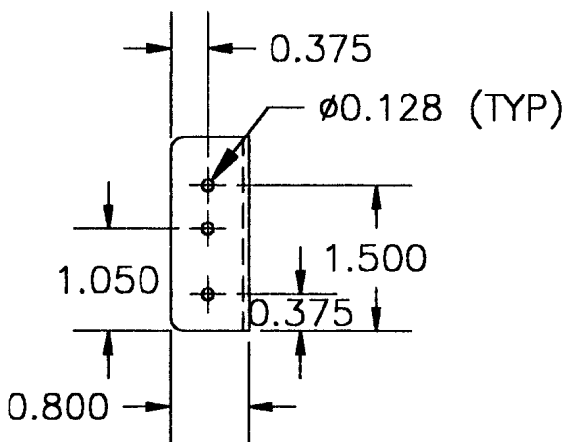

BEND RADIUS: 0.125  
MATERIAL: 5052-H34 0.063 THICK